


SUITE 109
1465 RSF

SUITE 107
2331 RSF

SUITE 101
4338 RSF

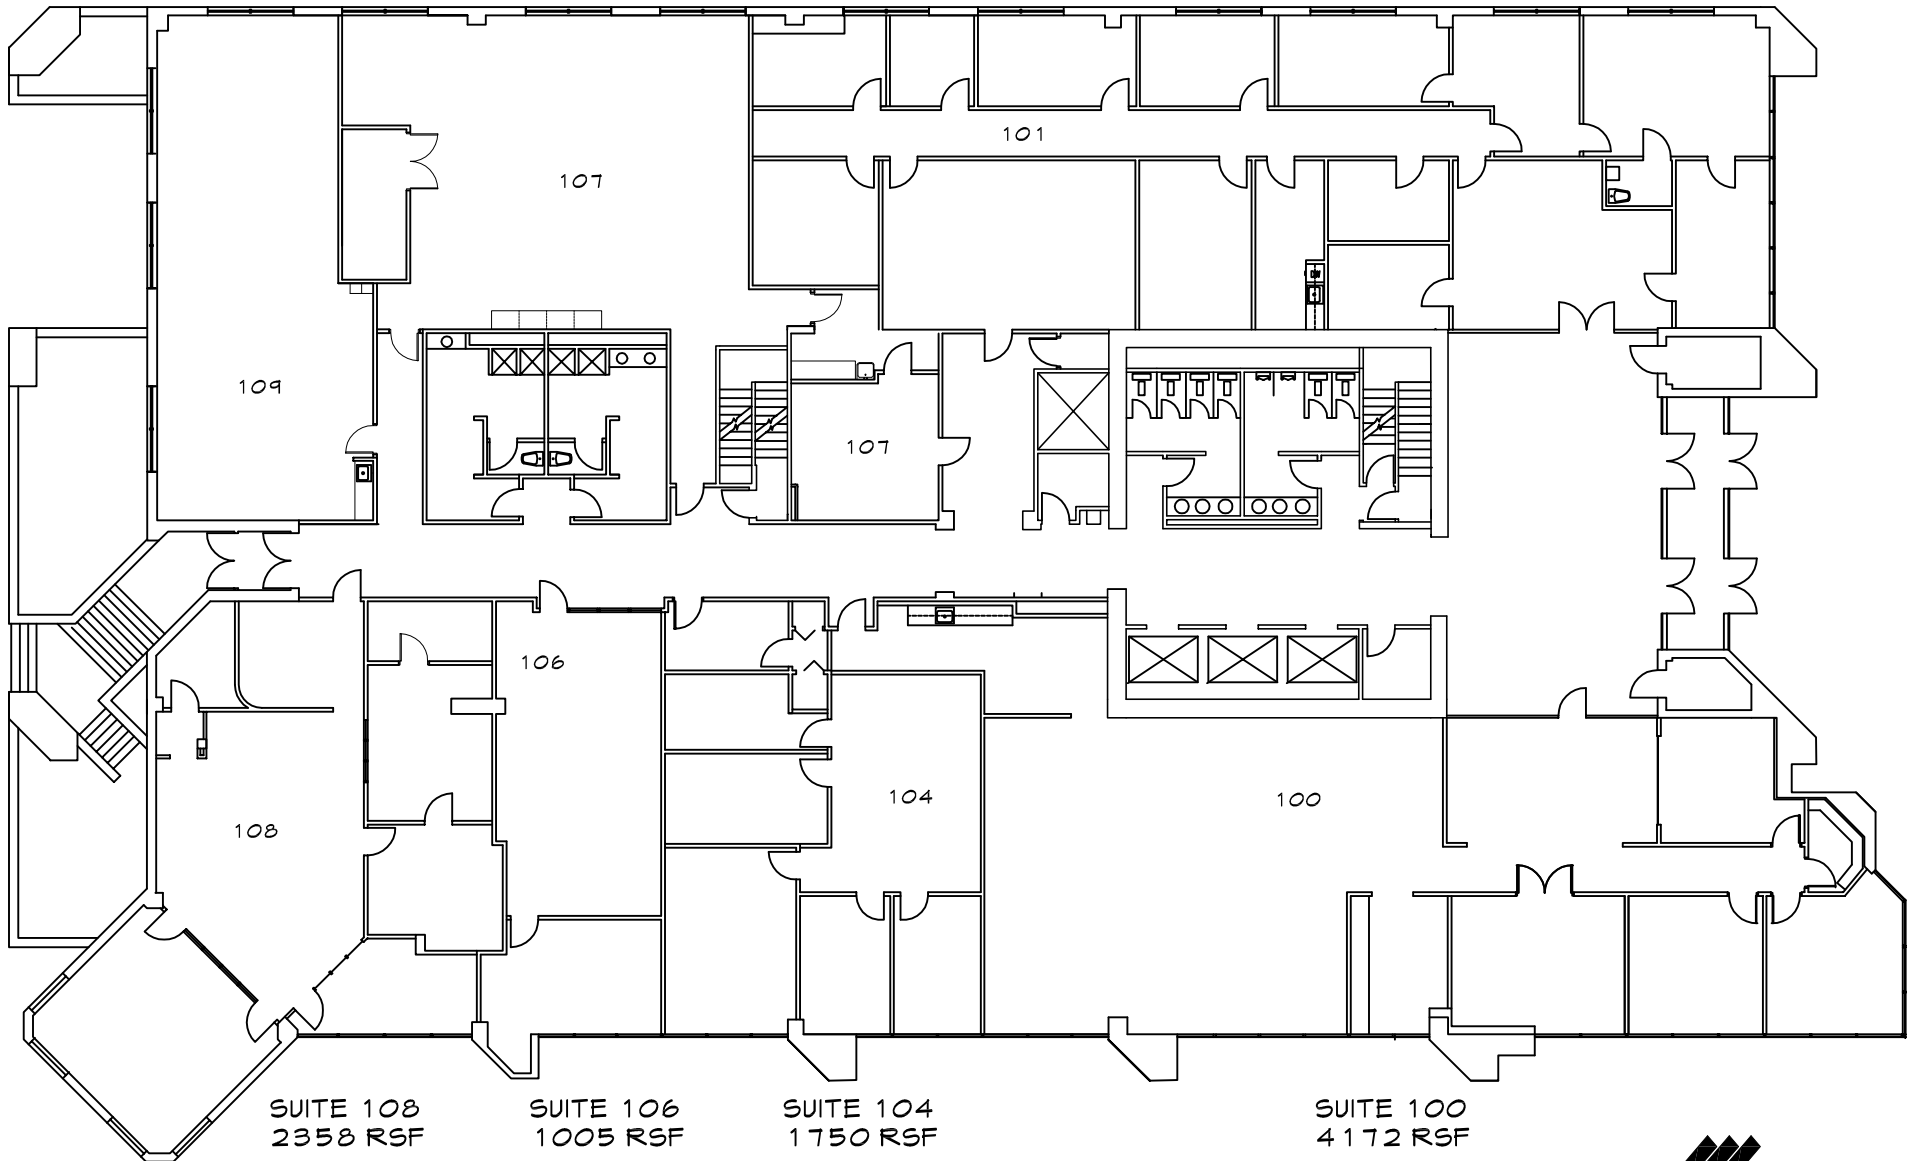

A FLOOR PLAN 

SCALE: N.T.S.

NORTH

NTS
1.21.2016

1ST FLOOR
MAPCO PLAZA



MAPCO PLAZA
1717 South Boulder
Tulsa, Oklahoma 74119



KKT ARCHITECTS, INC.
2200 SOUTH UTICA PLACE, SUITE 200
TULSA, OKLAHOMA 74114
[P] 918.744.4270 \ [F] 918.744.7849
WWW.KKTARCHITECTS.COM