



ARCHITECTURE \ INTERIORS \ ENGINEERING

KKT ARCHITECTS, INC.
2200 SOUTH UNICA PLACE, SUITE 200
TULSA, OKLAHOMA 74114
[P] 918.744.4270 \ [F] 918.744.7849
WWW.KKTARCHITECTS.COM

10TH FLOOR AS-BUILT

MAPCO PLAZA
1717 S BOULDER
10TH FLOOR




MAPCO PLAZA
1717 South Boulder
Tulsa, Oklahoma 74119

12.30.2015

.....

AS-BUILT
PLAN

AS-10

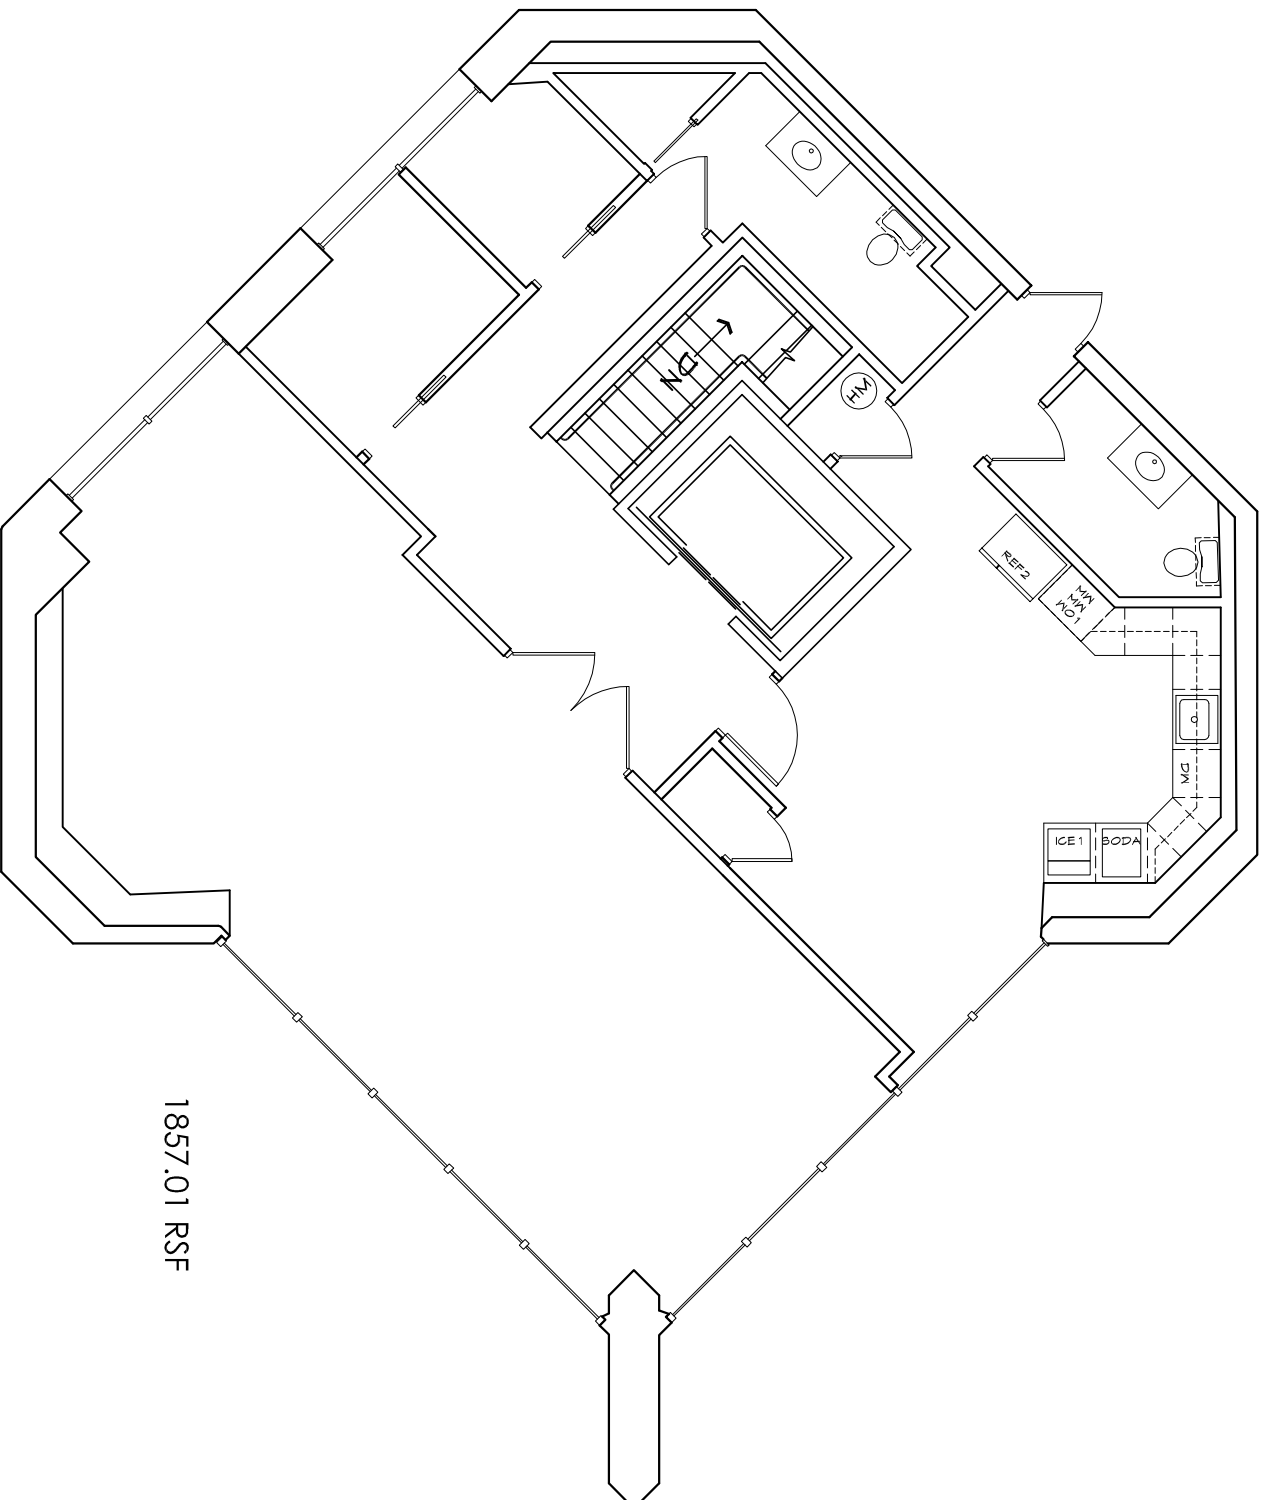

1857.01 RSF

A 10TH FLOOR PLAN

SCALE: 1/8" = 1'-0"



NORTH